

Work Order ID 67076

Monday, March 07, 2011 2:41:47 PM



Page 1

Item ID: D2580-1

Accept



Setup Start



Revision ID:

Stop



Item Name: 205 Skidtube bent detail

Start Date: 3/7/2011 Start Qty: 2.00



Cust Item ID:

Required Date: 3/18/2011 Req'd Qty: 2.00



Customer:

Reference:

Approvals: Process Plan: _____ Date: _____ Tooling: _____ Date: _____

QC: _____ Date: _____ SPC (Y/N): _____ Date: _____

Run Start



Stop



| Sequence ID/ Work Center ID | Operation Description | Set Up/ Run Hours | Tool ID | Tool # | Plan Code | Accept Qty | Reject Qty | Reject Number | Insp. Stamp |
|--------------------------------|--------------------------|----------------------|---------|--------|--------------|---------------|---------------|------------------|----------------|
|--------------------------------|--------------------------|----------------------|---------|--------|--------------|---------------|---------------|------------------|----------------|

| Draw Nbr | Revision Nbr |
|----------|--------------|
| D2580 | RevD DEO-D1 |

100

0.00



Skidtubes

Skidtubes

Memo

0.00

1- Inspect mat'l D2500-1-190 for damage.

2-Drill pilot holes using drill jig DT 8149 (Do not use cutting fluid)

3-Open holes to 0.500" as per Dwg D2580 without cutting fluid

4-Deburr holes per QSI002 section 4.2.3 and blow out all chips from inside of tube

5- Chemical Conversion Coat as per QSI 005 4.1

6-Bond web in place per QSI 015.

□□

A/R Sikaflex-291 batch: 116040 □□□

Sikaflex expire date: 11/07/08

Start time and date: 3:30 bond for 12hrs

BB 11/03/05

BB 11/03/05

2

BB 11/03/08

| W/O: | | WORK ORDER CHANGES | | | | | |
|------|------|--------------------|----|------|-----|-------------------------------------|--------------------------|
| DATE | STEP | PROCEDURE CHANGE | By | Date | Qty | Approval Chief Eng / Prod Mgr | Approval QC Inspector |
| | | | | | | | |
| | | | | | | | |

Part No: _____ PAR #: _____ Fault Category: _____ NCR: Yes No DQA: _____ Date: _____

Resolution: _____ Disposition: _____ QA: N/C Closed: _____ Date: _____

| NCR: | | WORK ORDER NON-CONFORMANCE (NCR) | | | | | | |
|------|------|----------------------------------|-----------------------------|---------------------------------|----------------|---------------------------|-----------------------|--------------------------|
| DATE | STEP | Description of NC Section A | Corrective Action Section B | | | Verification Section C | Approval Chief Eng | Approval QC Inspector |
| | | | Initial Chief Eng | Action Description Chief Eng | Sign & Date | | | |
| | | | | | | | | |
| | | | | | | | | |
| | | | | | | | | |

NOTE: Date & initial all entries

Work Order ID 67076

Monday, March 07, 2011 2:41:47 PM



Page 2

Item ID: D2580-1

Accept



Setup Start



Revision ID:

Stop



Item Name: 205 Skidtube bent detail

Start Date: 3/7/2011 Start Qty: 2.00



Cust Item ID:

Required Date: 3/18/2011 Req'd Qty: 2.00



Customer:

Reference:

Approvals: Process Plan: _____ Date: _____ Tooling: _____ Date: _____

Run Start



QC: _____ Date: _____ SPC (Y/N): _____ Date: _____

Stop

Sequence ID/
Work Center IDOperation
DescriptionSet Up/
Run Hours

Tool ID

Tool # Plan
CodeAccept
QtyReject
QtyReject
NumberInsp.
Stamp

101

QC6- Inspect dimensions to drawing

0.00



QC

Memo

0.00

Quality Control

DP

11-3-14

130

QC3- Inspect Part Finish

0.00



QC

Memo

0.00

Quality Control

DP

11-3-14

140

Identify as per dwg & Stock Location: L/K

0.00



Packaging

Memo

0.00

Packaging

DP

11-3-14

②

| W/O: | | WORK ORDER CHANGES | | | | | |
|------|------|--------------------|----|------|-----|-------------------------------------|--------------------------|
| DATE | STEP | PROCEDURE CHANGE | By | Date | Qty | Approval Chief Eng / Prod Mgr | Approval QC Inspector |
| | | | | | | | |
| | | | | | | | |

Part No: _____ PAR #: _____ Fault Category: _____ NCR: Yes No DQA: _____ Date: _____

Resolution: _____ Disposition: _____ QA: N/C Closed: _____ Date: _____

| NCR: | | WORK ORDER NON-CONFORMANCE (NCR) | | | | | | |
|------|------|----------------------------------|--------------------------------|---------------------------------|----------------|---------------------------|-----------------------|--------------------------|
| DATE | STEP | Description of NC Section A | Corrective Action Section B | | | Verification Section C | Approval Chief Eng | Approval QC Inspector |
| | | | Initial Chief Eng | Action Description Chief Eng | Sign & Date | | | |
| | | | | | | | | |
| | | | | | | | | |
| | | | | | | | | |

NOTE: Date & initial all entries

Work Order ID 67076

Page 3

Monday, March 07, 2011 2:41:47 PM

Item ID: D2580-1

Accept



Setup Start



Revision ID:

Stop



Item Name: 205 Skidtube bent detail

Start Date: 3/7/2011 Start Qty: 2.00



Cust Item ID:

Required Date: 3/18/2011 Req'd Qty: 2.00



Customer:

Reference:

Run Start



Approvals:

Process Plan: _____

Date: _____

Tooling: _____

Date: _____

Stop



QC: _____

Date: _____

SPC (Y/N): _____

Date: _____

Sequence ID/
Work Center IDOperation
DescriptionSet Up/
Run Hours

Tool ID

Tool #

Plan
CodeAccept
QtyReject
QtyReject
NumberInsp.
Stamp

150

QC21- Final Inspection - Work Order Release

0.00



QC

Memo

0.00

Quality Control

11/3/14

MF
11-03-14

| W/O: | | WORK ORDER CHANGES | | | | | |
|------|------|--------------------|----|------|-----|-------------------------------------|--------------------------|
| DATE | STEP | PROCEDURE CHANGE | By | Date | Qty | Approval Chief Eng / Prod Mgr | Approval QC Inspector |
| | | | | | | | |
| | | | | | | | |

Part No: _____ PAR #: _____ Fault Category: _____ NCR: Yes No DQA: _____ Date: _____

Resolution: _____ Disposition: _____ QA: N/C Closed: _____ Date: _____

| NCR: | | WORK ORDER NON-CONFORMANCE (NCR) | | | | | | |
|------|------|----------------------------------|-----------------------------|---------------------------------|----------------|---------------------------|-----------------------|--------------------------|
| DATE | STEP | Description of NC Section A | Corrective Action Section B | | | Verification Section C | Approval Chief Eng | Approval QC Inspector |
| | | | Initial Chief Eng | Action Description Chief Eng | Sign & Date | | | |
| | | | | | | | | |
| | | | | | | | | |
| | | | | | | | | |

NOTE: Date & initial all entries

Picklist Print

Page 1

Monday, March 07, 2011 2:41:43 PM

Work Order ID: 67076

Parent Item: D2580-1

Parent Item Name: 205 Skidtube bent detail

Start Date: 3/7/2011

Required Date: 3/18/2011

Start Qty: 2.00

Required Qty: 2.00

Comments: IPP B01.11.08 Revised Step 9, 10, 12, and 13 SM 10.12.01 as per DEO D1 DD verf:ec IPP Rev:C

| Component Item ID/ Item Name | Replacement Item ID | Mfg/ Purch | Bin Item | Primary Location | Last Location | Route Seq ID | Unit of Measure | Qty on Hand | Qty per Kit | Total Qty | Qty Issued | Date Issued | Status |
|---------------------------------|------------------------|---------------|-------------|---------------------|------------------|-----------------|--------------------|----------------|-------------|--------------|---------------|----------------|--------|
|---------------------------------|------------------------|---------------|-------------|---------------------|------------------|-----------------|--------------------|----------------|-------------|--------------|---------------|----------------|--------|

D2500-1-190

Manufactured

No

100

Each

58.0000

1

2



Ext'n -I' Beam Tube 4"

Location

Loc Qty

Loc Code

LG

58

52319

5

58427

53

D2596

Manufactured

No

100

Each

1.0000

1

2



Web, 205 Skidtube

Location

Loc Qty

Loc Code

LG

1

65508

1

67076

2

BB 11/02/08

BB 11/03/09

| W/O: | | WORK ORDER CHANGES | | | | | |
|------|------|--------------------|----|------|-----|-------------------------------------|--------------------------|
| DATE | STEP | PROCEDURE CHANGE | By | Date | Qty | Approval Chief Eng / Prod Mgr | Approval QC Inspector |
| | | | | | | | |
| | | | | | | | |

Part No: _____ PAR #: _____ Fault Category: _____ NCR: Yes No DQA: _____ Date: _____

Resolution: _____ Disposition: _____ QA: N/C Closed: _____ Date: _____

| NCR: | | WORK ORDER NON-CONFORMANCE (NCR) | | | | | | |
|------|------|----------------------------------|-----------------------------|---------------------------------|----------------|---------------------------|-----------------------|--------------------------|
| DATE | STEP | Description of NC Section A | Corrective Action Section B | | | Verification Section C | Approval Chief Eng | Approval QC Inspector |
| | | | Initial Chief Eng | Action Description Chief Eng | Sign & Date | | | |
| | | | | | | | | |
| | | | | | | | | |
| | | | | | | | | |

NOTE: Date & initial all entries

DART

| | | | |
|------------------|----------------|--|------------------------|
| DESIGN # | DRAWN BY RH | DART AEROSPACE LTD HAWKESBURY, ONTARIO, CANADA | |
| CHECKED # | APPROVED # | DRAWING NO. D2580 | REV. D SHEET 1 OF 3 |
| DATE 07.02.27 | | TITLE 205 SKIDTUBE ASSEMBLY | SCALE NTS |
| A | 96.09.16 | NEW ISSUE | |
| B | 96.12.02 | AS MANUFACTURED | |
| C | 98.08.26 | REDRAWN, INCLUDED DEO 9094/9097 | |
| D | 07.02.27 | CHANGE TO SS WEARPLATES AND GASKETS, INCLUDE DEO 9124/9183 | |

RELEASED
07.06.28 #**DEO ATTACHED**

| QTY -041 | QTY -045 | Part Number | Description |
|-------------|-------------|---|-------------------|
| X | | D2580-041 | SKIDTUBE ASSEMBLY |
| | X | D2580-045 | SKIDTUBE ASSEMBLY |
| 1 | 1 | D2500-1-190 | EXTRUSION |
| 1 | 1 | D2576-3 | STEP |
| 20 | 24 | D2579 | CROSS BOLT SPACER |
| 16 | 16 | D2594-1 | PLUG |
| 16 | 16 | D2594-3 | O-RING |
| 1 | 1 | D2596 | 205 WEB |
| 1 | 1 | D2855 | AFT CAP |
| 1 | 1 | D3564-5 | WEARSHOE |
| 1 | 1 | D3564-9 | WEARSHOE |
| 1 | 1 | D3564-11 | WEARSHOE |
| 1 | 1 | D3564-13 | WEARSHOE |
| 2 | 2 | D3566-1 | GASKET |
| 1 | 1 | D3566-5 | GASKET |
| 1 | 1 | D3566-13 | GASKET |
| 50 | 50 | ALS7-1032-130 or AKS7-1032-130 or AKS4-1032-130 or AELS-1032-130 | INSERT |
| 50 | 50 | AN3C4A | BOLT |
| 2 | 2 | AN3-5A | BOLT |
| 50 | 50 | AN960C10L | WASHER |
| 2 | 2 | AN960JD10L | WASHER |

C211103107

W10167076

GENERAL NOTES:

- 1) TOLERANCES ARE PER DART QSI 018 UNLESS OTHERWISE NOTED
- 2) ALL DIMENSIONS ARE IN INCHES
- 3) INSERT D2596 WEB TO LOCATION SHOWN OFF AFT END OF SKIDTUBE AND BOND WEB INTO OUTER TUBE WITH NON-STRUCTURAL SIKAFLEX-241 ADHESIVE PER DART QSI 015 BEFORE BENDING. ENSURE HOLES LINE-UP.
- 4) BEND AS A SMOOTH RADIUS STARTING WITH A MAXIMUM CENTERLINE RADIUS OF 60 AND ENDING WITH A MINIMUM RADIUS OF 30. A MAXIMUM REDUCTION OF 0.200 IN DIAMETER IS ALLOWABLE IN THE BENT PORTION OF THE TUBE.
- 5) USE DART DRILL TEMPLATE TD2577-205 TO LOCATE AND DRILL Ø0.297 HOLES FOR WEARSHOE INSERTS. INSTALL ALS7-1032-130 PER SECTION D-D (50 PLACES) AFTER FINISH. INSTALL AN3C4A BOLTS AND AN960C10L WASHERS WITH SIKAFLEX-241/-291.
- 6) WELDING TO BE DONE PER DART QSI 004.
- 7) FINISH:
SEE NOTES ON
PAGE 2 FOR D2580-041 AND
PAGE 3 FOR D2580-045
- 8) INSERT D2594-1 PLUG C/W D2594-3 O-RING IN HOLES MARKED 'P' (BOTH SIDES OF TUBE) AFTER FINISH (16 PLACES).

Copyright © 1996 by DART AEROSPACE LTD

THIS DOCUMENT IS PRIVATE AND CONFIDENTIAL AND IS SUPPLIED ON THE EXPRESS CONDITION THAT IT IS NOT TO BE USED FOR ANY PURPOSE OR COPIED OR COMMUNICATED TO ANY OTHER PERSON WITHOUT WRITTEN PERMISSION FROM DART AEROSPACE LTD.

| W/O: | | WORK ORDER CHANGES | | | | | |
|------|------|--------------------|----|------|-----|-------------------------------------|--------------------------|
| DATE | STEP | PROCEDURE CHANGE | By | Date | Qty | Approval Chief Eng / Prod Mgr | Approval QC Inspector |
| | | | | | | | |
| | | | | | | | |


Part No: _____ PAR #: _____ Fault Category: _____ NCR: Yes No DQA: _____ Date: _____

Resolution: _____ Disposition: _____ QA: N/C Closed: _____ Date: _____


| NCR: | | WORK ORDER NON-CONFORMANCE (NCR) | | | | | | |
|------|------|----------------------------------|-----------------------------|---------------------------------|----------------|---------------------------|-----------------------|--------------------------|
| DATE | STEP | Description of NC Section A | Corrective Action Section B | | | Verification Section C | Approval Chief Eng | Approval QC Inspector |
| | | | Initial Chief Eng | Action Description Chief Eng | Sign & Date | | | |
| | | | | | | | | |
| | | | | | | | | |
| | | | | | | | | |

NOTE: Date & initial all entries

DETAIL A
SCALE 5:24

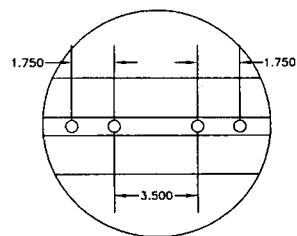


DETAIL B
SCALE 5:24

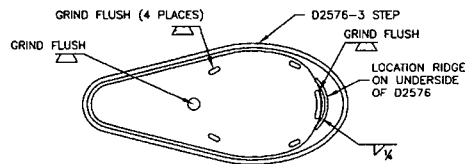


RELEASED
07.06.28

DEO ATTACHED

DETAIL C
SCALE 5:24

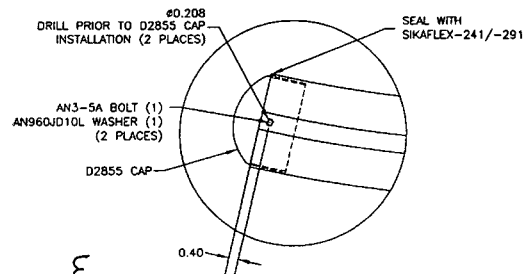


SECTION D-D
SCALE 5:24

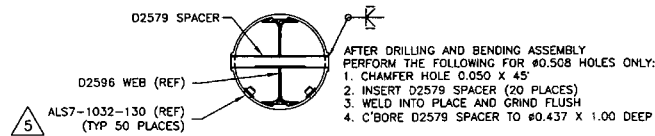


- AFTER DRILLING AND BENDING ASSEMBLY PERFORM THE FOLLOWING FOR #0.508 HOLES ONLY:
1. CHAMFER HOLE 0.050 X 45°
 2. INSERT D2579 SPACER (20 PLACES)
 3. WELD INTO PLACE AND GRIND FLUSH
 4. C'BORE D2579 SPACER TO #0.437 X 1.00 DEEP


D2580-1 DRILLING DETAIL

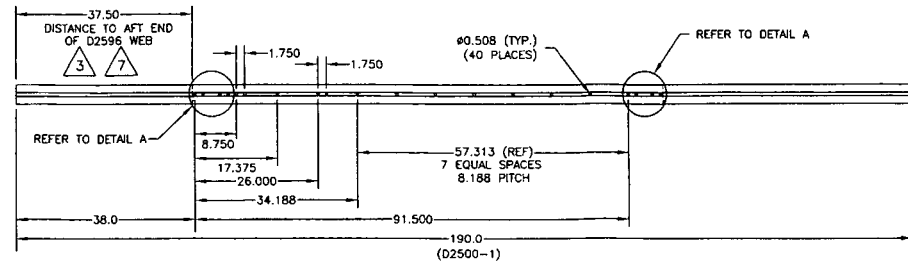

D2580-1 BENDING AND CUTTING DETAIL

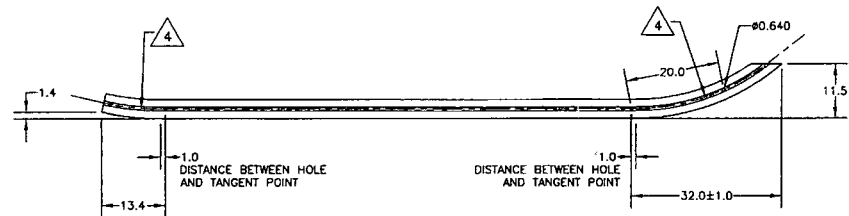

D2580-041 ASSEMBLY DETAIL

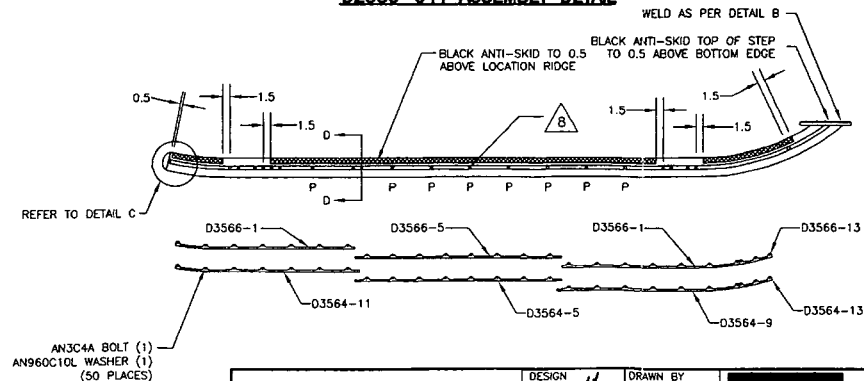

D2580-041 NOTES

- i) FINISH: ACID ETCH, ALODINE PER DART QSI 005 4.1 PRIOR TO INSERTING D2596 WEB
POWDER COAT ASSEMBLY GLOSS WHITE (REF. 4.3.5.1) PER DART QSI 005 4.3
BLACK ANTI-SKID PAINT AS INDICATED PER DART QSI 005 4.4

COPYRIGHT © 1996 BY DART AEROSPACE LTD.

THIS DOCUMENT IS PRIVATE AND CONFIDENTIAL AND IS SUPPLIED ON THE EXPRESS CONDITION THAT IT IS NOT TO BE USED FOR ANY PURPOSE OR COPIED OR COMMUNICATED TO ANY OTHER PERSON WITHOUT WRITTEN PERMISSION FROM DART AEROSPACE LTD.

| | | | |
|----------|----------|-----------------------|--|
| DESIGN | DRAWN BY | DART | DART AEROSPACE LTD. MARKESBURY, ONTARIO, CANADA |
| CHECKED | APPROVED | DRAWING NO. | REV. D |
| DATE | | D2580 | SHEET 2 OF 3 |
| 07.02.27 | | TITLE | SCALE |
| | | 205 SKIDTUBE ASSEMBLY | 1:24 |

| W/O: | | WORK ORDER CHANGES | | | | | |
|------|------|--------------------|----|------|-----|-------------------------------------|--------------------------|
| DATE | STEP | PROCEDURE CHANGE | By | Date | Qty | Approval Chief Eng / Prod Mgr | Approval QC Inspector |
| | | | | | | | |
| | | | | | | | |


Part No: _____ PAR #: _____ Fault Category: _____ NCR: Yes No DQA: _____ Date: _____

Resolution: _____ Disposition: _____ QA: N/C Closed: _____ Date: _____

| NCR: | | WORK ORDER NON-CONFORMANCE (NCR) | | | | | | |
|------|------|----------------------------------|-----------------------------|---------------------------------|----------------|---------------------------|-----------------------|--------------------------|
| DATE | STEP | Description of NC Section A | Corrective Action Section B | | | Verification Section C | Approval Chief Eng | Approval QC Inspector |
| | | | Initial Chief Eng | Action Description Chief Eng | Sign & Date | | | |
| | | | | | | | | |
| | | | | | | | | |
| | | | | | | | | |

NOTE: Date & initial all entries


D2580-1 DRILLING DETAIL

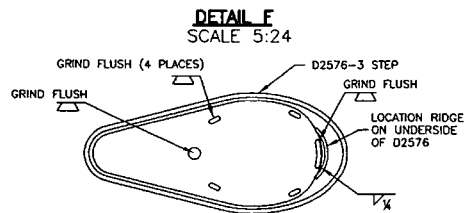


RELEASED
67-66-28

DEO ATTACHED

D2580-5 BENDING AND CUTTING DETAIL
(MAKE FROM D2580-1 DRILLING DETAIL)

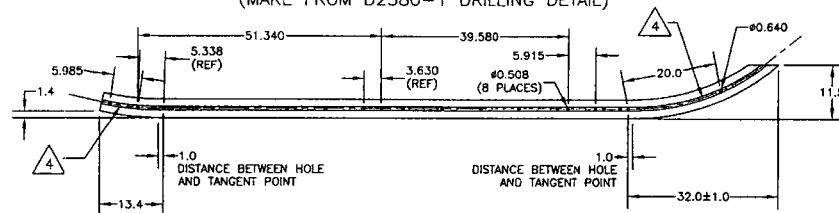

D2580-045 ASSEMBLY DETAIL

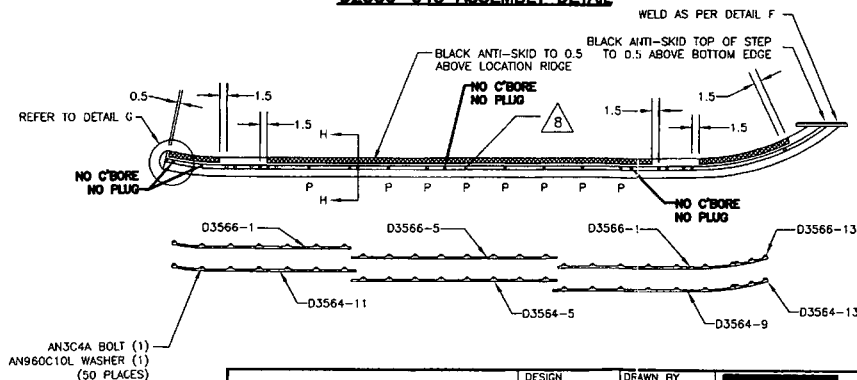

COPYRIGHT © 1996 BY DART AEROSPACE LTD.

- i) **FINISH:** ACID ETCH, ALODINE PER DART QSI 005 4.1 PRIOR TO INSERTING D2596 WEB
POWDER COAT ENTIRE ASSEMBLY GREEN (REF. 4.3.5.8) PER DART QSI 005 4.3
BLACK ANTI-SKID PAINT AS INDICATED PER DART QSI 005 4.4
- ii) IT IS ACCEPTABLE TO GRIND A RELIEF IN THE D2855 AFT CAP TO PREVENT INTERFERENCE
WITH THE SPACER AT THIS LOCATION

| | | | |
|---------------------|--------------------------------|----------------------|--|
| DESIGN <i>RH</i> | DRAWN BY <i>RH</i> | DART | DART AEROSPACE LTD. HAMPSHIRE, ONTARIO, CANADA |
| CHECKED <i>H</i> | APPROVED <i>H</i> | DRAWING NO. D2580 | REV. D SHEET 3 OF 3 |
| DATE 07.02.27 | TITLE 205 SKIDTUBE ASSEMBLY | | SCALE 1:24 |

| W/O: | | WORK ORDER CHANGES | | | | | |
|------|------|--------------------|----|------|-----|-------------------------------------|--------------------------|
| DATE | STEP | PROCEDURE CHANGE | By | Date | Qty | Approval Chief Eng / Prod Mgr | Approval QC Inspector |
| | | | | | | | |
| | | | | | | | |

Part No: _____ PAR #: _____ Fault Category: _____ NCR: Yes No DQA: _____ Date: _____

Resolution: _____ Disposition: _____ QA: N/C Closed: _____ Date: _____

| NCR: | | WORK ORDER NON-CONFORMANCE (NCR) | | | | | | |
|------|------|----------------------------------|-----------------------------|---------------------------------|----------------|---------------------------|-----------------------|--------------------------|
| DATE | STEP | Description of NC Section A | Corrective Action Section B | | | Verification Section C | Approval Chief Eng | Approval QC Inspector |
| | | | Initial Chief Eng | Action Description Chief Eng | Sign & Date | | | |
| | | | | | | | | |
| | | | | | | | | |
| | | | | | | | | |

NOTE: Date & initial all entries

| | | | | | | | |
|----------------------|--------------------------------|------------------------|---|--|-------------------------|---------------------------|--------------|
| DRAWING NO. D2580 | TITLE 205 SKIDTUBE ASSEMBLY | REV. D | DART AEROSPACE LTD ENGINEERING ORDER | | D.E.O. NO. D2580-D-1 | SHEET NO. SHEET 1 OF 1 | SCALE NTS |
| DRAWN <i>UP</i> | CHECKED <i>L</i> | MFG. APPR. <i>E</i> | APPROVED <i>MP</i> | | DE APPR. <i>H</i> | | |
| DATE 10.09.22 | DATE 10.11.04 | DATE 10.11.04 | DATE 10/11/04 | | DATE 10.11.04 | | |

PURPOSE:

CHANGE ALL WELDED CROSSBOLT SPACERS TO SWAGED SPACERS

CHANGE:

PARTS LIST IS AMENDED AS FOLLOWS:


WAS

| QTY -041 | QTY -045 | PART NUMBER | DESCRIPTION |
|-------------|-------------|-------------|-------------------|
| 20 | 24 | D2579 | CROSS BOLT SPACER |

IS

| | | | |
|----|----|---------|--------|
| 20 | 24 | D4202-1 | SPACER |
|----|----|---------|--------|

SECTION D-D & SECTION H-H ARE AMENDED AS FOLLOWS:

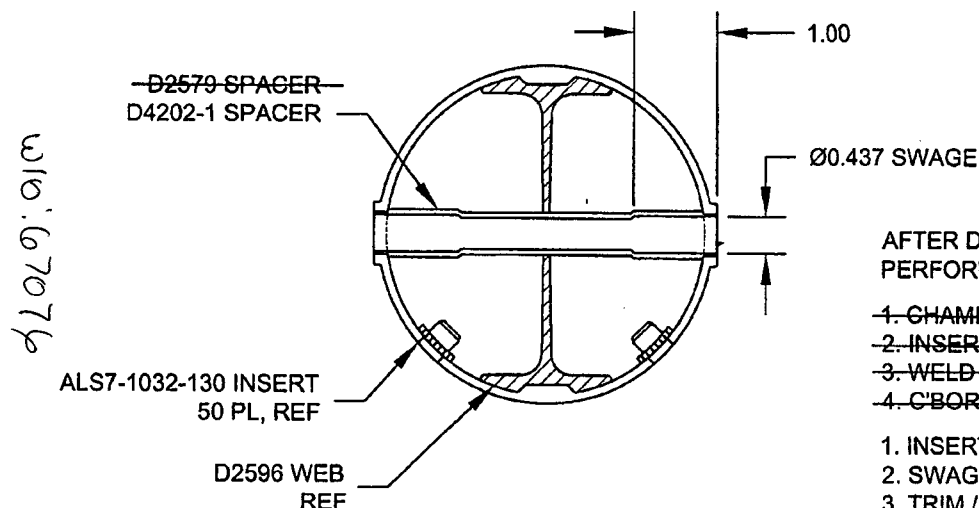

SECTION D-D
NOT TO SCALE

SECTION H-H
NOT TO SCALE

RELEASED
2010-11-18
MP

AFTER DRILLING AND BENDING ASSEMBLY
PERFORM THE FOLLOWING FOR Ø0.508 HOLES ONLY:

- ~~1. CHAMFER HOLE 0.050 X 45°~~
- ~~2. INSERT D2579 SPACER (20 PLACES)~~
- ~~3. WELD INTO PLACE AND GRIND FLUSH~~
- ~~4. C-BORE D2579 SPACER TO Ø0.437 X 1.00 DEEP~~

1. INSERT D4202-1 SPACER, 20 PL (-041) OR 24 PL (-045)
2. SWAGE TO Ø0.437 X 1.00 DEEP PER QSI 002
3. TRIM / GRIND FLUSH PER QSI 002

COPYRIGHT © 2010 BY DART AEROSPACE LTD
THIS DOCUMENT IS PRIVATE AND CONFIDENTIAL AND IS SUPPLIED ON THE EXPRESS CONDITION THAT IT IS
NOT TO BE USED FOR ANY PURPOSE OR COPIED OR COMMUNICATED TO ANY OTHER PERSON WITHOUT
WRITTEN PERMISSION FROM DART AEROSPACE LTD.

| W/O: | | WORK ORDER CHANGES | | | | | |
|------|------|--------------------|----|------|-----|-------------------------------------|--------------------------|
| DATE | STEP | PROCEDURE CHANGE | By | Date | Qty | Approval Chief Eng / Prod Mgr | Approval QC Inspector |
| | | | | | | | |
| | | | | | | | |

Part No: _____ PAR #: _____ Fault Category: _____ NCR: Yes No DQA: _____ Date: _____

Resolution: _____ Disposition: _____ QA: N/C Closed: _____ Date: _____

| NCR: | | WORK ORDER NON-CONFORMANCE (NCR) | | | | | | |
|------|------|----------------------------------|--------------------------------|---------------------------------|----------------|---------------------------|-----------------------|--------------------------|
| DATE | STEP | Description of NC Section A | Corrective Action Section B | | | Verification Section C | Approval Chief Eng | Approval QC Inspector |
| | | | Initial Chief Eng | Action Description Chief Eng | Sign & Date | | | |
| | | | | | | | | |
| | | | | | | | | |
| | | | | | | | | |

NOTE: Date & initial all entries